
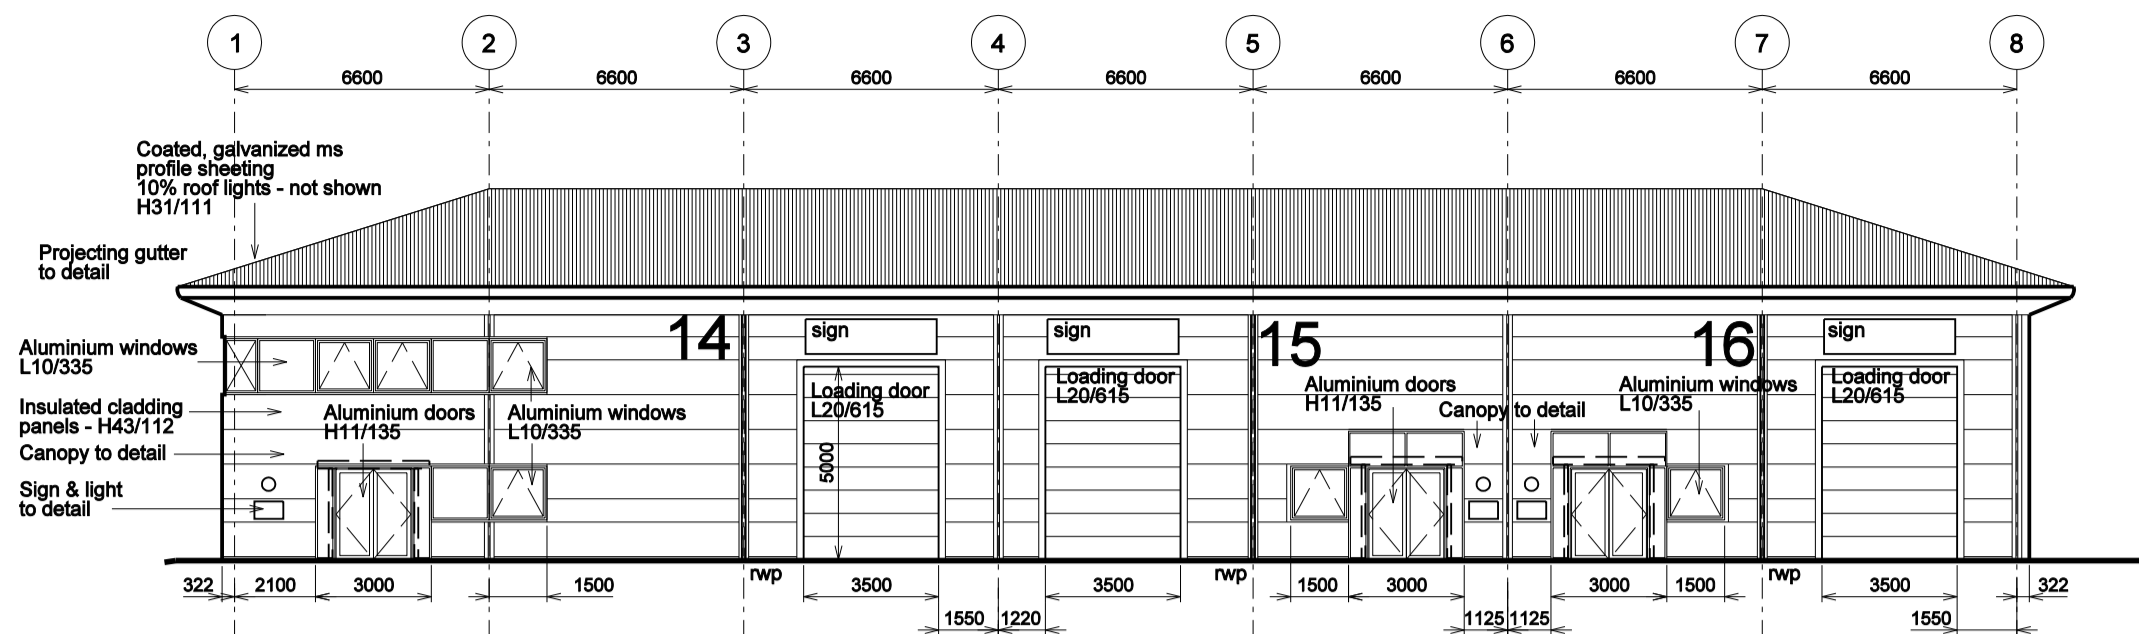



**NOTES**

Do not scale. Work only to figured dimensions. Subject to Statutory Approvals.


Where applicable this drawing is to be read in conjunction with other consultants drawings and with the specification.

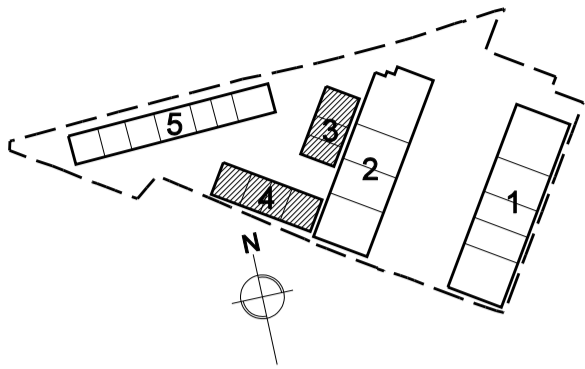


**8** Terrace 3 - North west elevation  
Scale 1:200

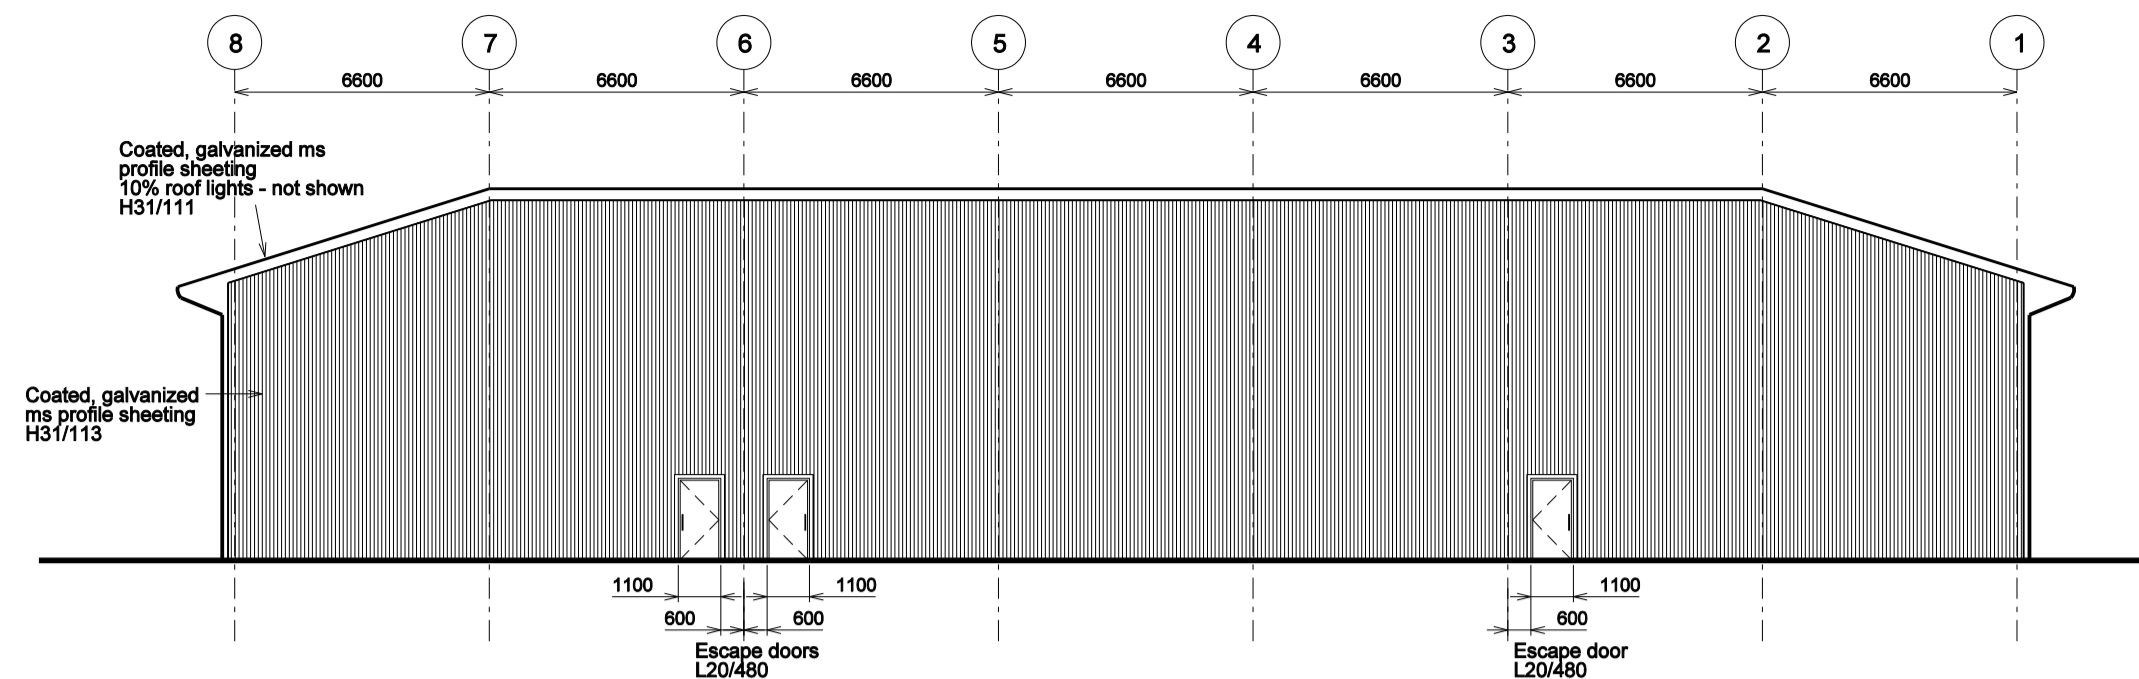


**7** Terrace 3 - South east elevation  
Scale 1:200

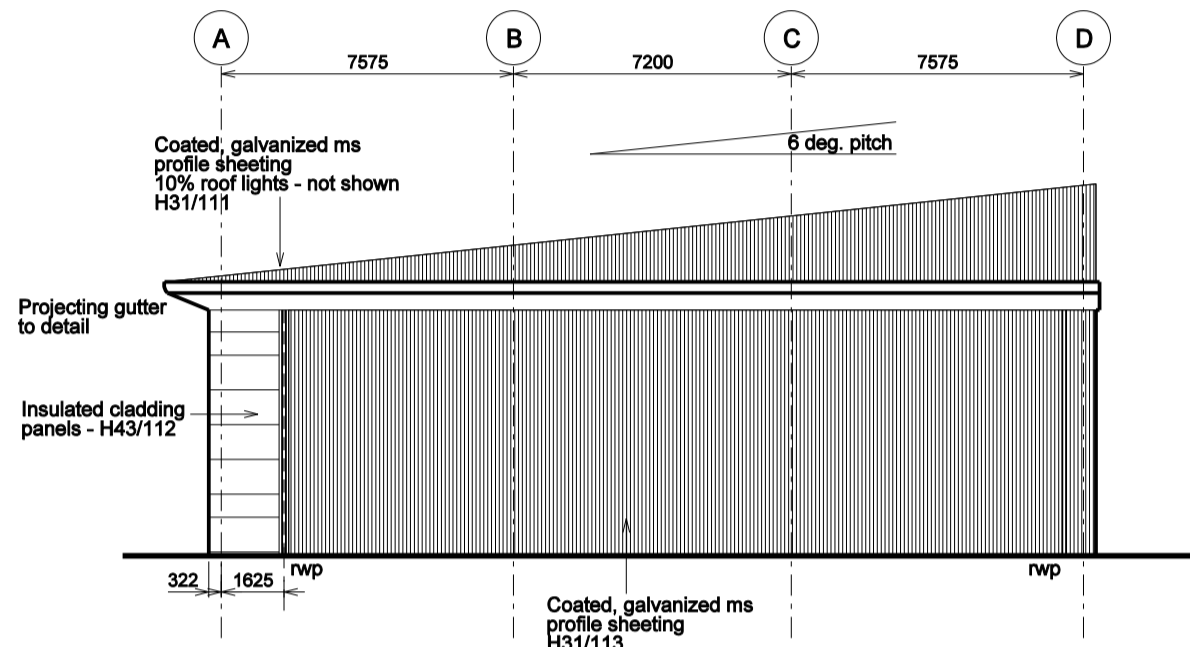


**6** Terrace 3 - North east elevation  
Scale 1:200

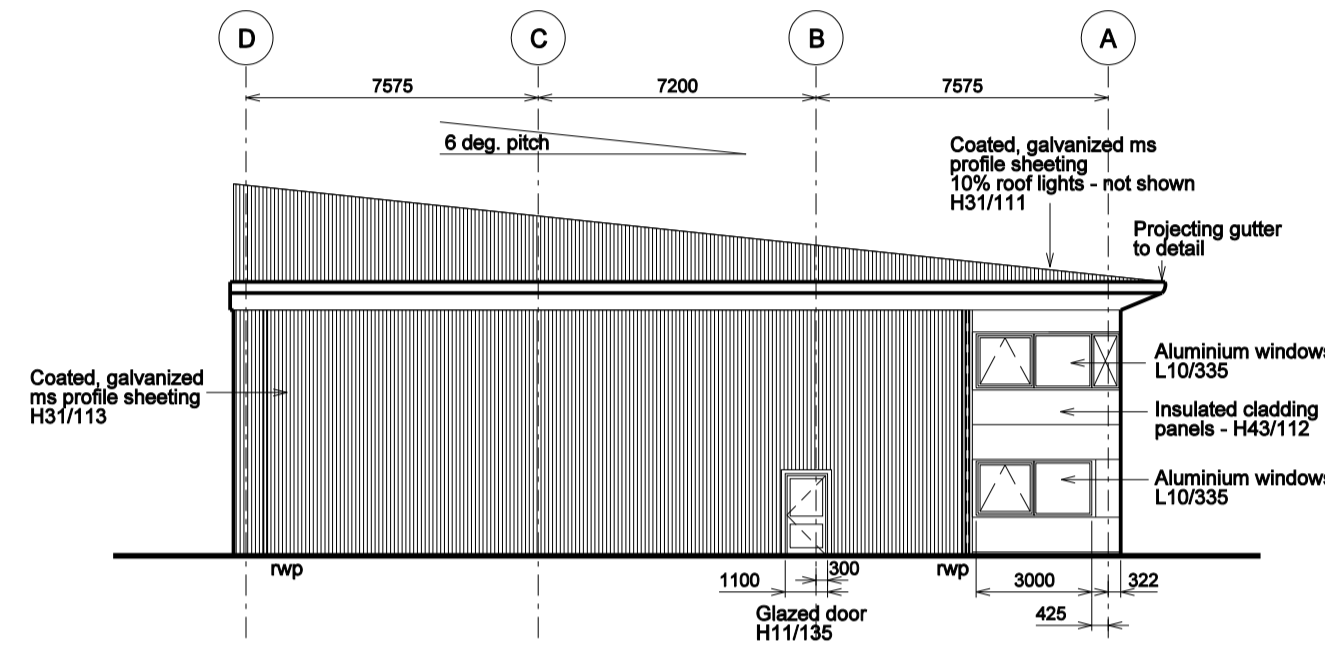


**5** Terrace 3 - South west elevation  
Scale 1:200

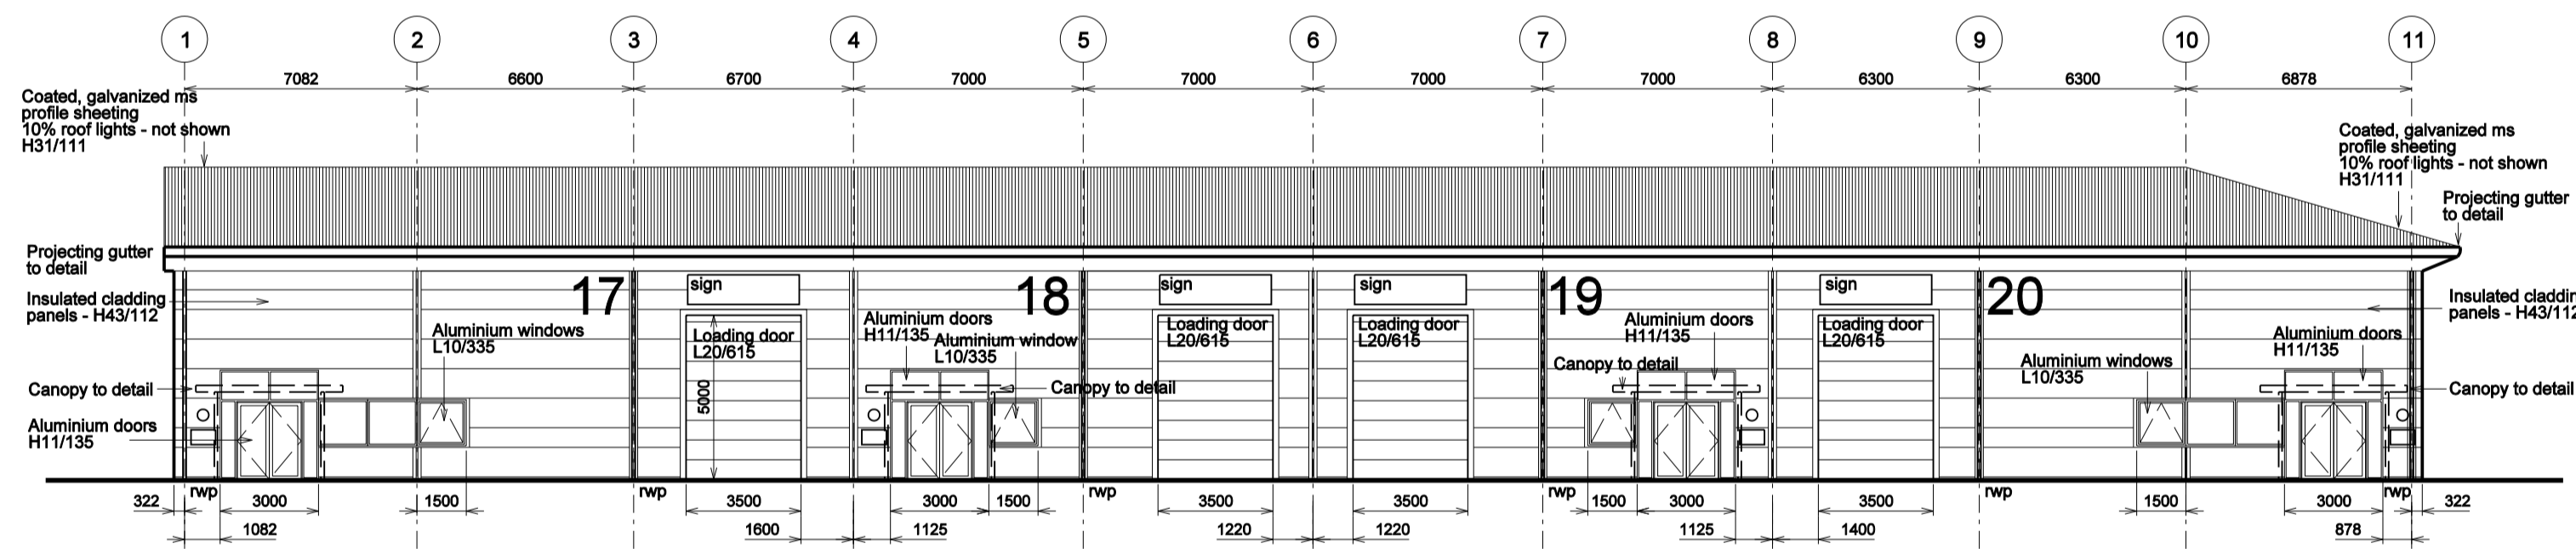


**4** Terrace 4 - North east elevation  
Scale 1:200

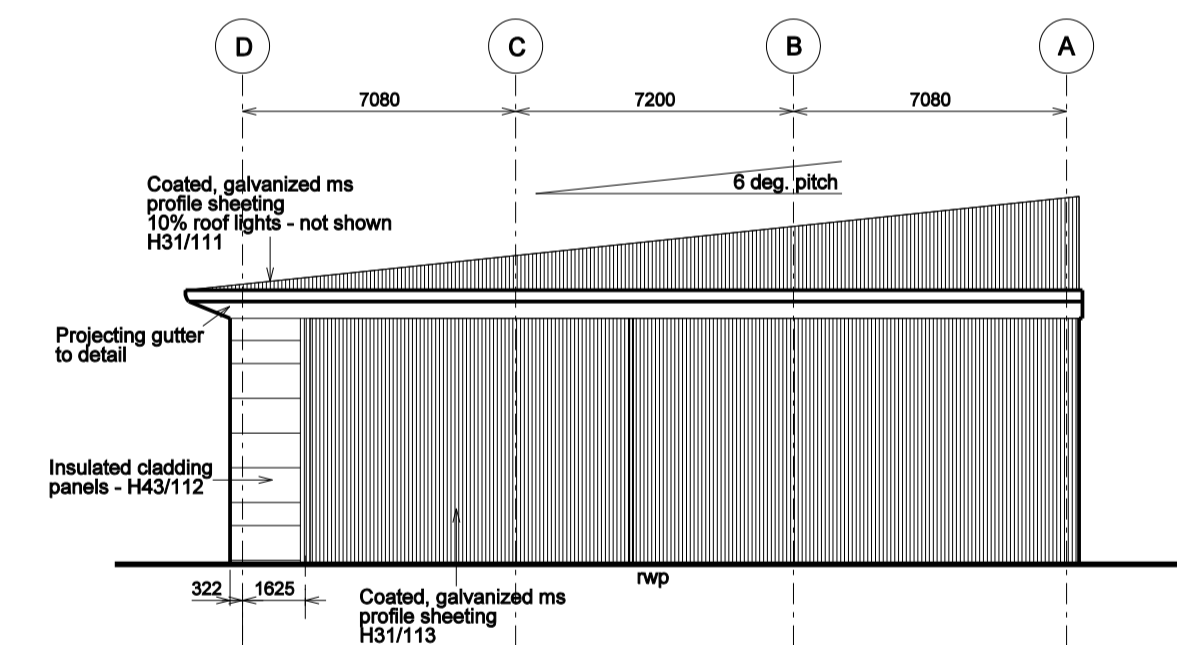

**3** Terrace 4 - North west elevation  
Scale 1:200

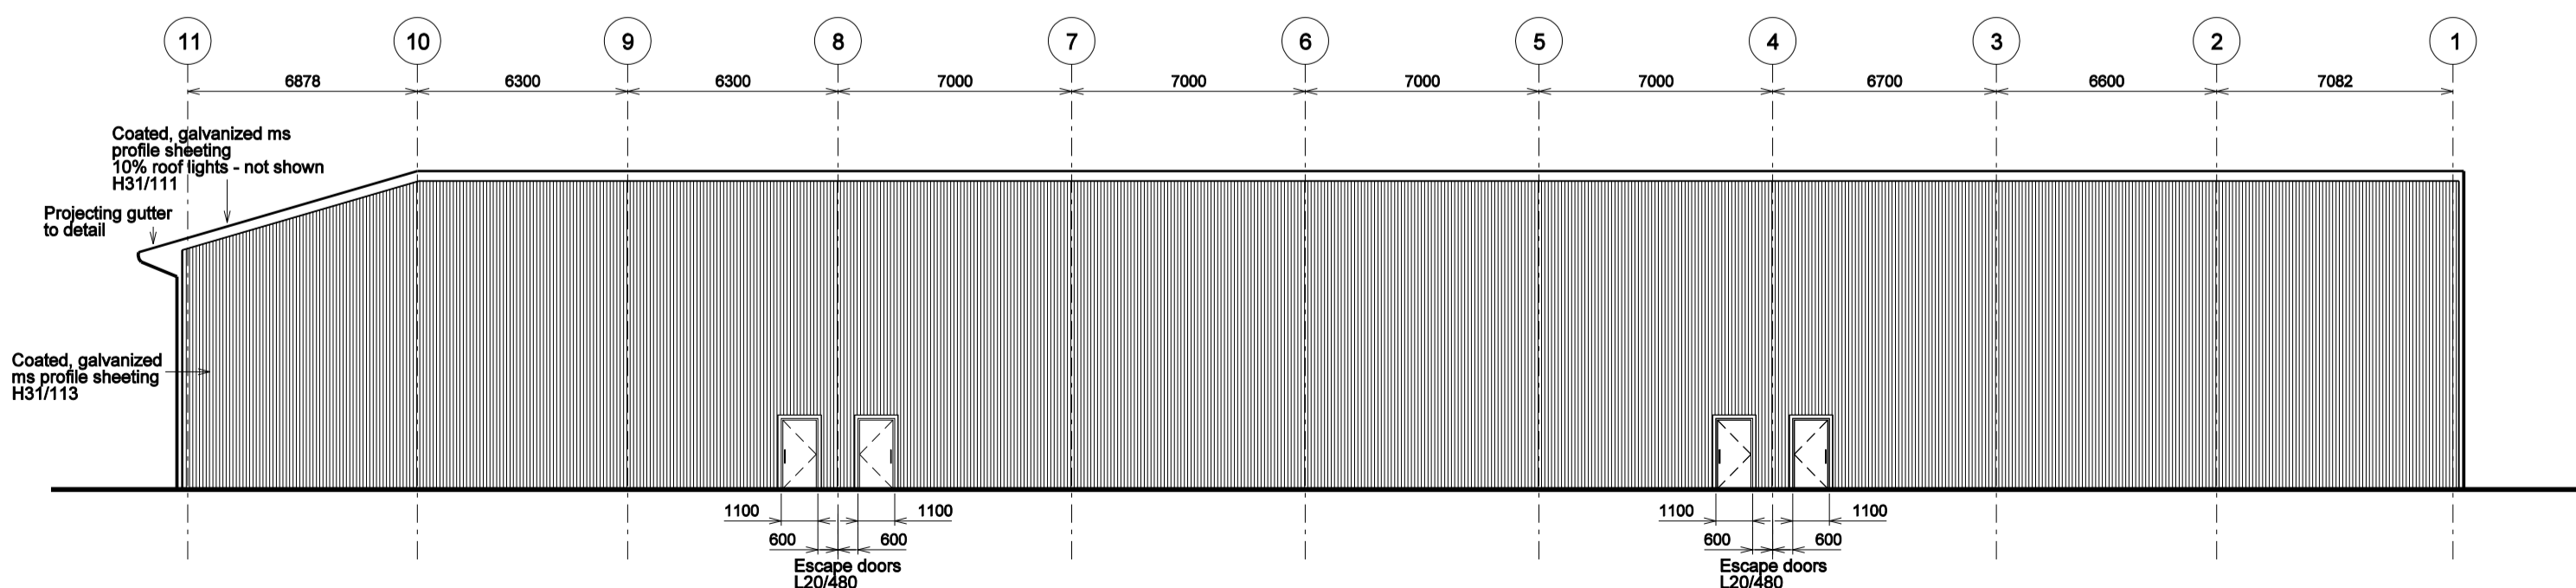

**2** Terrace 4 - South west elevation  
Scale 1:200

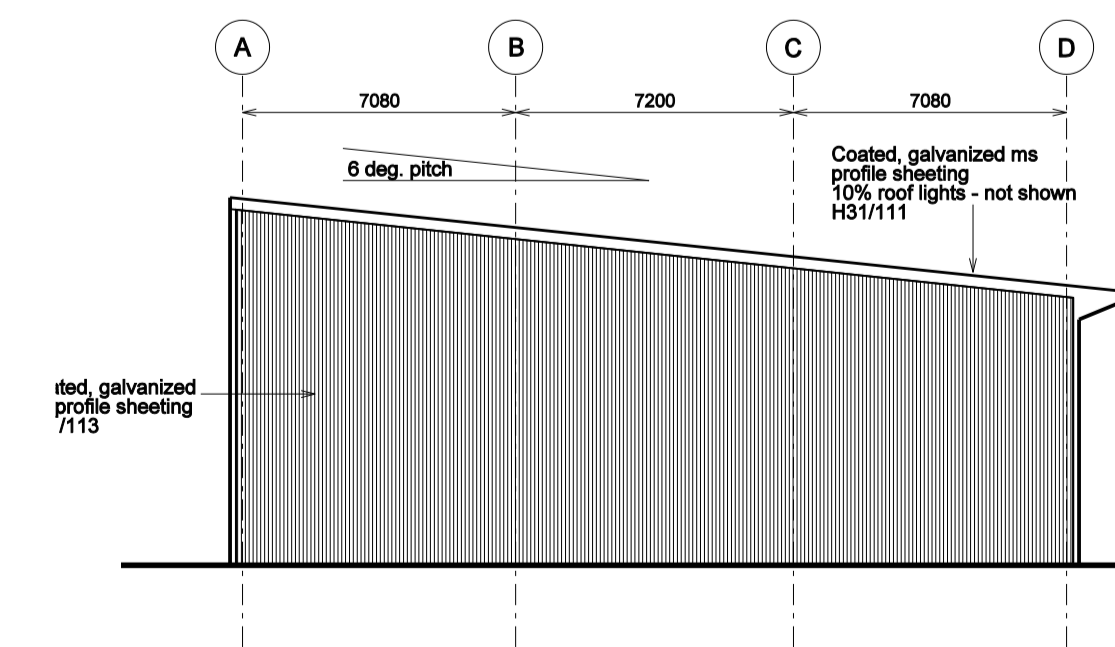

**1** Terrace 4 - South east elevation  
Scale 1:200

ABI	As built issue	cy	100907
C	General updated, RWP amended to suit HS'0rg.	cy	020707
B	RWP added	bd	23.01.07
A	Notes added, drg resetup, RWP added	bd	19.01.07
Rev	Description	Chkd	Date

Priony House  
25 St Johns Lane  
London EC1M 4HD

tel +44(0)20 7253 9692  
fax +44(0)20 7253 0846

enquiries@cornish-architects.co.uk  
www.cornish-architects.co.uk

**cornisharchitects**

**Project** Greenford Park  
Blue Zone Development  
West Site

**Drg Title** Terraces 3&4 - Units 14 to 20  
GA Elevations  
(Phase 2)

**Status** A S BUILT



**Scale** 1:200 @ A1 **Date** 080906

**Drg No** 10555 / WD/ 216 **REV** AB1

Copyright of Cornish Architects ©